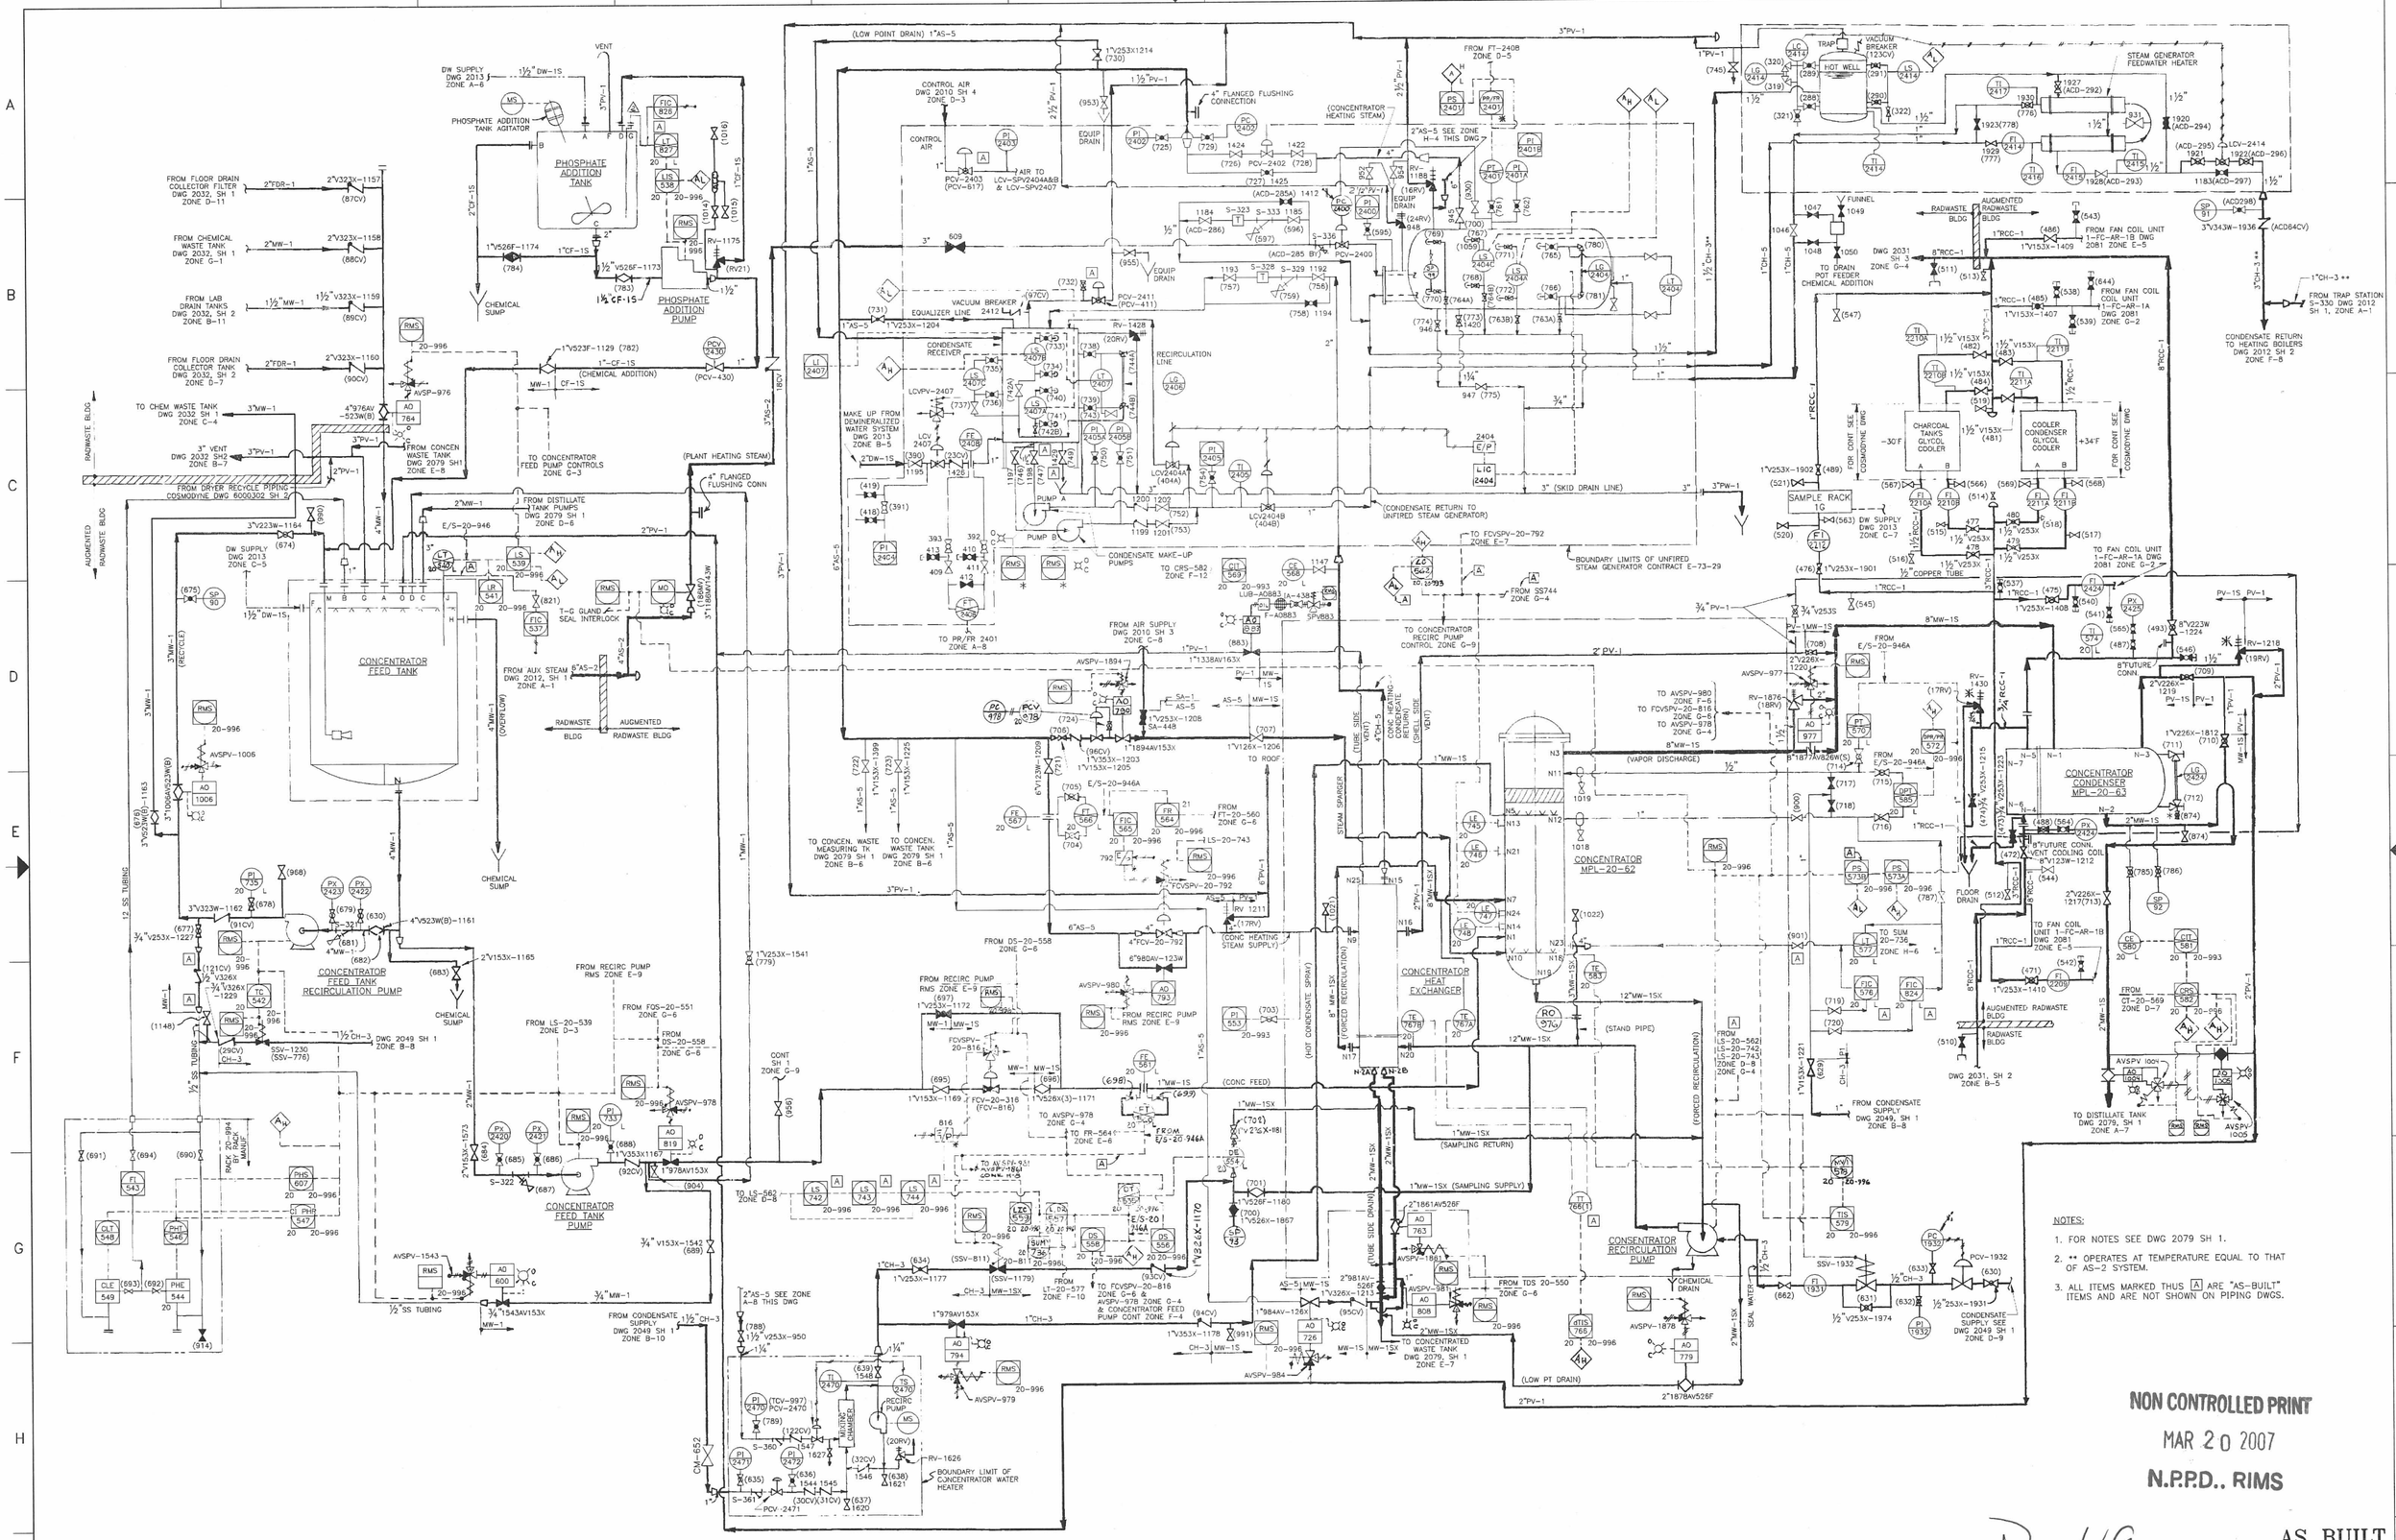

NON CONTROLLED PRINT

MAR 20 2007

N.P.P.D., RIMS

D-49

AS BUILT
454003660
SCAN/CADD DWG
DO NOT REVISE MANUALLY

REVISIONS BY N.P.P.D				
NO.	REVISIONS	DFT	CKD	APP	DATE
N28	REDRAWN TO CAD (DCN 03-0107)	RGA	KG	DLR	2/19/03
N30	EE 03-082 (DCN 03-1144)	DLR	DLR	PLM	1/30/04
N31	CED 6016200 (DCN 04-2885)	RGA	DLR	KG	7/28/05

COOPER NUCLEAR STATION
FLOW DIAGRAM
AUGMENTED LIQUID
RADWASTE SYSTEM

DRAWN RGA	DATE 12/19/02	BURNS & ROE
CHECKED	DATE	
APPROVED	DATE	
FILMED	2079 SH 2	REVISION N31

CADD FILE: C0036337